

Date: Tuesday, 22/07/2008 11:22:05 AM
 User: Julie Lecocq

Process Sheet

Customer :	CU-DAR001 Dart Helicopters Services	Drawing Name :	350 SKIDTUBE ASSEMBLY LH
Job Number :	40696	Part Number :	D350636011
Estimate Number :	10262	Drawing Number :	D2750 UNDER REVIEW
P.O. Number :		Project Number :	N/A
This Issue :	22/07/2008	Drawing Revision :	UPDATE PER DSI 9413
Prsht Rev. :	NC	Material :	
First Issue :	11	Due Date :	10/08/2008
Previous Run :	39972	Qty:	1 Um: Each
Written By :			
Checked & Approved By :	JUD 08.722		
Comment :	Est Rev: I 02.09.25 Rearranged procedure steps KJ Est Rev: J 06-03-23 As per Rev D JLM Est Rev: K 06-07.13 As per dsi9343 EC Est Rev: L 07-07-28 Added SS Wearplates (Rev E) JLM Verified By: EC Est Rev: M 08-04-22 update steps 4, 13 DD verified by: EC		

Additional Product

Job Number:



Seq. #:	Machine Or Operation:	Description :
---------	-----------------------	---------------

1.0	DC	DOCUMENT CONTROL
-----	----	------------------



8/8/7



Comment: DOCUMENT CONTROL

Photocopy blue file and type labels per PPP D350-636-011 CHG 004 PH 08.07.22 + DSI 9413

2.0	D26003BENT	Extrusion Bent
-----	------------	----------------



Comment: Qty.: 1.0000 Each(s)/Unit Total: 1.0000 Each(s)

Pick:

Qty	Part Number	Description	Batch
1	D2600-3-Bent	Extrusion (Bent)	2714 SL 8-7-29

3.0	D2744	Cap
-----	-------	-----



Comment: Qty.: 1.0000 Each(s)/Unit Total: 1.0000 Each(s)

Cap

Batch: 37768 SL 8-7-30

4.0	SKIDTUBES 1	SKIDTUBESS RESOURCE 1
-----	-------------	-----------------------



Comment: LANDING GEAR RESOURCE 1

1- Mark cut line on aft end of D2600-3-Bent using Jig DT 8150. Cut to length as per Dwg D2750. Deburr end

2-Drill pilot holes as per Dwg D2750 sheet 3 (D2750-1 details). Drill using drill Jig DT8150 & DT8863.

SL 8-7-30

W/O:		WORK ORDER CHANGES					
DATE	STEP	PROCEDURE CHANGE	By	Date	Qty	Approval Chief Eng / Prod Mgr	Approval QC Inspector

Part No: _____ PAR #: _____ Fault Category: _____ NCR: Yes No DQA: _____ Date: _____

QA: N/C Closed: _____ Date: _____

NCR:		WORK ORDER NON-CONFORMANCE (NCR)						
DATE	STEP	Description of NC Section A	Corrective Action Section B			Verification Section C	Approval Chief Eng	Approval QC Inspector
			Initial Chief Eng	Action Description Chief Eng	Sign & Date			

NOTE: Date & initial all entries

Process Sheet

Customer: CU-DAR001 Dart Helicopters Services

Drawing Name: 350 SKIDTUBE ASSEMBLY LH

Job Number: 40696

Part Number: D350636011

Job Number:



Seq. #:

Machine Or Operation:

Description :

3- Mark fwd end for cutting using Drill Jig DT 8150 & DT8863 and cut as per dwg D2750.

4-Drill pilot holes for Detail G using DT8330

5-Open up holes for Detail B to 0.375" (4 holes per side) and blade fitting location holes to 0.500" (total of 5 holes per side) as per dwg D2750. Open up holes for ground handling and detail E to 0.500" (8 holes per side)

6-Drill pilot holes for wearplates as per Dwg D2750 using DT8108

****Make sure that wearplate holes are on bottom of tube***** Open 4 aft wearplate holes to 0.250". Open remaining wearplate holes to 0.297"

7-Open up holes of Detail A to 0.297" (total of 2 holes per side)

9-Weld D2744 Cap as per Dwg D2750 and QSI 004. Fill grooves in bend left from bending as per QSI 004
A/R Aluminum Rod *M 108096 / m b 7877* *BE 08/07/30*

10-Grind welds flush as per Dwg D2750

12- Scribe batch# inside per dwg D2750

3L8-7-30

) H 8-7-30

5.0

QC10

VISUAL INSPECTION OF GROUND WELDS



Comment: VISUAL INSPECTION OF GROUND WELDS

S 08/07/30 (40)

6.0

QC5

INSPECT WORK TO CURRENT STEP



Comment: INSPECT WORK TO CURRENT STEP

S 08/07/30 (40)

7.0

HAND FINISHING1

HAND FINISHING RESOURCE #1



Comment: HAND FINISHING RESOURCE #1

Chemical Conversion Coat as per QSI 005 4.1

H 8-7-30

8.0

QC3

INSPECT POWDER COAT/CHEMICAL CONVERSION



Comment: INSPECT POWDER COAT/CHEMICAL CONVERSION

BE 08-07-30

W/O:		WORK ORDER CHANGES						
DATE	STEP	PROCEDURE CHANGE	By	Date	Qty	Approval Chief Eng / Prod Mgr	Approval QC Inspector	

Part No: _____ PAR #: _____ Fault Category: _____ NCR: Yes No DQA: _____ Date: _____

QA: N/C Closed: _____ Date: _____

NCR:		WORK ORDER NON-CONFORMANCE (NCR)						
DATE	STEP	Description of NC Section A	Corrective Action Section B			Verification Section C	Approval Chief Eng	Approval QC Inspector
			Initial Chief Eng	Action Description Chief Eng	Sign & Date			

NOTE: Date & initial all entries

Date: Tuesday, 22/07/2008 11:22:05 AM
User: Julie Lecocq

Process Sheet

Customer: CU-DAR001 Dart Helicopters Services

Drawing Name: 350 SKIDTUBE ASSEMBLY LH

Job Number: 40696

Part Number: D350636011

Job Number:



Seq. #:

Machine Or Operation:

Description :

9.0

D2739

350 I Beam



Comment: Qty.: 1.0000 Each(s)/Unit Total : 1.0000 Each(s)

Web

Batch:

640723 ① M 8-7-30

10.0

D34901

Cross Bolt Spacer



Comment: Qty.: 4.0000 Each(s)/Unit Total : 4.0000 Each(s)

Crossbolt spacer

Batch:

232584 RE 8-7-31

11.0

D34903

Cross Bolt Spacer



Comment: Qty.: 4.0000 Each(s)/Unit Total : 4.0000 Each(s)

Crossbolt spacer

Batch:

240727 RE 8-7-31

12.0

D2743

Crossbolt Spacer



Comment: Qty.: 8.0000 Each(s)/Unit Total : 8.0000 Each(s)

Crossbolt Spacer

Batch:

238755 RE 8-7-31

13.0

SKIDTUBES 1

SKIDTUBESS RESOURCE 1



Comment: LANDING GEAR RESOURCE 1

1-Open up holes of Detail E and ground handling to 0.625" (total of 8 holes per side) as per dwg D2750.

2-Open up holes of Detail B to 0.750" (total of 4 holes per side) as per dwg D2750.

3- Open float hole to 0.500" (4 per side)

4-Chamfer holes of Detail B, E, ground handling and float holes per dwg D2750 (welding instructions on sheet 4)

5-Deburr and blow out all chips from inside of tube

6- Prepare tube for welding, remove alodine as required.

M
8-7-30

W/O:		WORK ORDER CHANGES						
DATE	STEP	PROCEDURE CHANGE	By	Date	Qty	Approval Chief Eng / Prod Mgr	Approval QC Inspector	

Part No: _____ PAR #: _____ Fault Category: _____ NCR: Yes No DQA: _____ Date: _____

QA: N/C Closed: _____ Date: _____

NCR:		WORK ORDER NON-CONFORMANCE (NCR)						
DATE	STEP	Description of NC Section A	Corrective Action Section B			Verification Section C	Approval Chief Eng	Approval QC Inspector
			Initial Chief Eng	Action Description Chief Eng	Sign & Date			

NOTE: Date & initial all entries

Date: Tuesday, 22/07/2008 11:22:05 AM
User: Julie Lecocq

Process Sheet

Customer: CU-DAR001 Dart Helicopters Services

Drawing Name: 350 SKIDTUBE ASSEMBLY LH

Job Number: 40696

Part Number: D350636011

Job Number:



Seq. #:

Machine Or Operation:

Description:

7-Bond web D2739 in place as per QSI 015

A/R

Sikaflex-291

batch:

exp. date:

M 07988

M 8-7-30

8-11-1

8- Weld spacers D3490-1, D3490-3 and D2743 as per dwg D2750 & QSI004

(welding instructions on sheet 4)

A/R

Aluminum Rod

batch:

M 108096

BE 8-7-31

9-Grind welds flush as per Dwg D2750

A.M 08.08.01

10-Spot face ground handling holes section P-P (total of 4 places per side) as per dwg D2750

A.M 08.08.01

11-Deburr holes

A.M 08.08.01

14.0

QC10

VISUAL INSPECTION OF GROUND WELDS



Comment: VISUAL INSPECTION OF GROUND WELDS

S 08/08/01

15.0

QC5

INSPECT WORK TO CURRENT STEP



Comment: INSPECT WORK TO CURRENT STEP

S 08/08/01

16.0

HAND FINISHING1

HAND FINISHING RESOURCE #1



Comment: HAND FINISHING RESOURCE #1

Pressure wash as per QSI 005

Rh/M 08/08/05

(X)

17.0

POWDER COATING

POWDER COATING



Comment: POWDER COATING

Powder Coat Gloss White (Ref. 4.3.5.1) as per Dart QSI 005 4.3

START TIME:

OVEN TEMPERATURE:

FINISH TIME:

11:50
320 OF
12:20

M. 08/08/05

(X)

18.0

QC3

INSPECT POWDER COAT/CHEMICAL CONVERSION



Comment: INSPECT POWDER COAT/CHEMICAL CONVERSION

Inspect for foreign object per QSI 024

08-08-05

(X)

Dart Aerospace Ltd

W/O:		WORK ORDER CHANGES						
DATE	STEP	PROCEDURE CHANGE	By	Date	Qty	Approval Chief Eng / Prod Mgr	Approval QC Inspector	

Part No: _____ PAR #: _____ Fault Category: _____ NCR: Yes No DQA: _____ Date: _____

QA: N/C Closed: _____ Date: _____

NCR:		WORK ORDER NON-CONFORMANCE (NCR)						
DATE	STEP	Description of NC Section A	Corrective Action Section B			Verification Section C	Approval Chief Eng	Approval QC Inspector
			Initial Chief Eng	Action Description Chief Eng	Sign & Date			

NOTE: Date & initial all entries

Date: Tuesday, 22/07/2008 11:22:05 AM
User: Julie Lecocq

Process Sheet

Customer: CU-DAR001 Dart Helicopters Services

Drawing Name: 350 SKIDTUBE ASSEMBLY LH

Job Number: 40696

Part Number: D350636011

Job Number:



Seq. #:

Machine Or Operation:

Description :

19.0

ALS41032225

Insert



33 *HL* 08.07.22



Comment: Qty.: ~~24~~ 0.0000 Each(s)/Unit Total: ~~2~~ 0.0000 Each(s)

Insert

Batch: M100489-

HL

20.0

HAND FINISHING1

HAND FINISHING RESOURCE #1



Comment: HAND FINISHING RESOURCE #1

Install inserts as per Dwg D2750

HL

08-08-05

(2)

21.0

D2745

Bushing



Comment: Qty.: 8.0000 Each(s)/Unit Total: 8.0000 Each(s)

Bushing

Batch: B36230

HL

22.0

D37931

Wearshoe



Comment: Qty.: 1.0000 Each(s)/Unit Total: 1.0000 Each(s)

WEARSHOE

Batch: B39715

HL

23.0

D353525

Wearshoe



Comment: Qty.: 1.0000 Each(s)/Unit Total: 1.0000 Each(s)

WEARSHOE

Batch: B39716

HL

24.0

D37933

Wearshoe



Comment: Qty.: 1.0000 Each(s)/Unit Total: 1.0000 Each(s)

WEARSHOE

Batch: B39812

HL

25.0

D37941

Gasket



Comment: Qty.: 1.0000 Each(s)/Unit Total: 1.0000 Each(s)

GASKET

Batch: B39421

HL

08-08-05

(2)

W/O:		WORK ORDER CHANGES						
DATE	STEP	PROCEDURE CHANGE	By	Date	Qty	Approval Chief Eng / Prod Mgr	Approval QC Inspector	

Part No: _____ PAR #: _____ Fault Category: _____ NCR: Yes No DQA: _____ Date: _____

QA: N/C Closed: _____ Date: _____

NCR:		WORK ORDER NON-CONFORMANCE (NCR)						
DATE	STEP	Description of NC Section A	Corrective Action Section B			Verification Section C	Approval Chief Eng	Approval QC Inspector
			Initial Chief Eng	Action Description Chief Eng	Sign & Date			

NOTE: Date & initial all entries

Date: Tuesday, 22/07/2008 11:22:05 AM
User: Julie Lecocq

Process Sheet

Customer: CU-DAR001 Dart Helicopters Services

Drawing Name: 350 SKIDTUBE ASSEMBLY LH

Job Number: 40696

Part Number: D350636011

Job Number:



Seq. #:

Machine Or Operation:

Description :

26.0

D353625

Gasket



Comment: Qty.: 1.0000 Each(s)/Unit Total: 1.0000 Each(s)

GASKET

Batch: 1340729

X

27.0

D37943

Gasket



Comment: Qty.: 1.0000 Each(s)/Unit Total: 1.0000 Each(s)

GASKET

Batch: 1339422

X

HL

28.0

D35371

Wearpad



Comment: Qty.: 1.0000 Each(s)/Unit Total: 1.0000 Each(s)

WEARPAD

Batch: 1338941

HL 01.07.22

3

HL

29.0

D36311

Washer



Comment: Qty.: 8.0000 Each(s)/Unit Total: 8.0000 Each(s)

WASHER

Batch: 1338139

HL

30.0

D3488041

Blade Fitting Assembly, LH



Comment: Qty.: 1.0000 Each(s)/Unit Total: 1.0000 Each(s)

Blade Fitting, LH

Batch: 1338786

HL

31.0

D3492041

Plug Assembly



Comment: Qty.: 8.0000 Each(s)/Unit Total: 8.0000 Each(s)

PLUG ASSEMBLY

Batch: 1339725

HL

32.0

D3492043

Plug Assembly



Comment: Qty.: 8.0000 Each(s)/Unit Total: 8.0000 Each(s)

PLUG ASSEMBLY

Batch: 1340728

HL

08-08-05

KL

Dart Aerospace Ltd

W/O:		WORK ORDER CHANGES					
DATE	STEP	PROCEDURE CHANGE	By	Date	Qty	Approval Chief Eng / Prod Mgr	Approval QC Inspector

Part No: _____ PAR #: _____ Fault Category: _____ NCR: Yes No DQA: _____ Date: _____

QA: N/C Closed: _____ Date: _____

NCR:		WORK ORDER NON-CONFORMANCE (NCR)						
DATE	STEP	Description of NC Section A	Corrective Action Section B			Verification Section C	Approval Chief Eng	Approval QC Inspector
			Initial Chief Eng	Action Description Chief Eng	Sign & Date			

NOTE: Date & initial all entries

Date: Tuesday, 22/07/2008 11:22:05 AM
User: Julie Lecocq

Process Sheet

Customer: CU-DAR001 Dart Helicopters Services

Drawing Name: 350 SKIDTUBE ASSEMBLY LH

Job Number: 40696

Part Number: D350636011

Job Number:



Seq. #:	Machine Or Operation:	Description :
---------	-----------------------	---------------

33.0	AN3C5A	Bolt
------	--------	------



34 PU 01.07.22



Comment: Qty.: 34 38.0000 Each(s)/Unit Total : 38.0000 Each(s)

Bolt

Batch: M108302

34.0	AN3C6A	BOLT
------	--------	------



Comment: Qty.: 4.0000 Each(s)/Unit Total : 4.0000 Each(s)

Bolt

Batch: M105300

35.0	AN3C7A	BOLT
------	--------	------



Comment: Qty.: 4.0000 Each(s)/Unit Total : 4.0000 Each(s)

BOLT

Batch:

DSI 9413
NOT REQ'D 01.07.22

36.0	AN6C44A	BOLT
------	---------	------



Comment: Qty.: 4.0000 Each(s)/Unit Total : 4.0000 Each(s)

BOLT

Batch: M108284

37.0	AN8C35A	BOLT
------	---------	------



Comment: Qty.: 1.0000 Each(s)/Unit Total : 1.0000 Each(s)

BOLT

Batch: M106896

38.0	AN960C10L	washer
------	-----------	--------



Comment: Qty.: 34 38.0000 Each(s)/Unit Total : 34 38.0000 Each(s)

washer

Batch: M108672

PU 01.07.22

39.0	AN960C816L	WASHER
------	------------	--------



Comment: Qty.: 1 20.0000 Each(s)/Unit Total : 20.0000 Each(s)

WASHER

Batch: M107520

1 PU 01.07.22

08.08.05 (10)

W/O:		WORK ORDER CHANGES						
DATE	STEP	PROCEDURE CHANGE	By	Date	Qty	Approval Chief Eng / Prod Mgr	Approval QC Inspector	

Part No: _____ PAR #: _____ Fault Category: _____ NCR: Yes No DQA: _____ Date: _____

QA: N/C Closed: _____ Date: _____

NCR:		WORK ORDER NON-CONFORMANCE (NCR)						
DATE	STEP	Description of NC Section A	Corrective Action Section B			Verification Section C	Approval Chief Eng	Approval QC Inspector
			Initial Chief Eng	Action Description Chief Eng	Sign & Date			

NOTE: Date & initial all entries

Date: Tuesday, 22/07/2008 11:22:05 AM
User: Julie Lecocq

Process Sheet

Customer: CU-DAR001 Dart Helicopters Services

Drawing Name: 350 SKIDTUBE ASSEMBLY LH

Job Number: 40696

Part Number: D350636011

Job Number:



Seq. #:	Machine Or Operation:	Description :
---------	-----------------------	---------------

40.0	MS210436	NUT
------	----------	-----



Comment: Qty.: 4.0000 Each(s)/Unit Total: 4.0000 Each(s)

NUT

Batch: M108744

YH

41.0	MS21083C8	NUT
------	-----------	-----



Comment: Qty.: 1.0000 Each(s)/Unit Total: 1.0000 Each(s)

NUT

Batch: M108744

YH

42.0	NAS1515H3L	WASHER
------	------------	--------



Comment: Qty.: 4.0000 Each(s)/Unit Total: 4.0000 Each(s)

WASHER

Batch: M107394

YH

43.0	NAS1515H8L	WASHER
------	------------	--------



Comment: Qty.: 2.0000 Each(s)/Unit Total: 2.0000 Each(s)

WASHER

Batch:

NOT REQ'D PER DSI 9413

PH 08.07.22

44.0	D37911	Wearplate
------	--------	-----------



Comment: Qty.: 1.0000 Each(s)/Unit Total: 1.0000 Each(s)

Wearplate B39694

YH

45.0	AN526C1032R10	Screw
------	---------------	-------



Comment: Qty.: 4.0000 Each(s)/Unit Total: 4.0000 Each(s)

Screw

Batch: M108062

YH

46.0	AN526C1032R18	Screw
------	---------------	-------



Comment: Qty.: 4.0000 Each(s)/Unit Total: 4.0000 Each(s)

Screw

Batch: M108079

YH

08.08.05

Dart Aerospace Ltd

W/O:		WORK ORDER CHANGES						
DATE	STEP	PROCEDURE CHANGE	By	Date	Qty	Approval Chief Eng / Prod Mgr	Approval QC Inspector	

Part No: _____ PAR #: _____ Fault Category: _____ NCR: Yes No DQA: _____ Date: _____

QA: N/C Closed: _____ Date: _____

NCR:		WORK ORDER NON-CONFORMANCE (NCR)						
DATE	STEP	Description of NC Section A	Corrective Action Section B			Verification Section C	Approval Chief Eng	Approval QC Inspector
			Initial Chief Eng	Action Description Chief Eng	Sign & Date			

NOTE: Date & initial all entries

Date: Tuesday, 22/07/2008 11:22:06 AM
User: Julie Lecocq

Process Sheet

Customer: CU-DAR001 Dart Helicopters Services

Drawing Name: 350 SKIDTUBE ASSEMBLY LH

Job Number: 40696

Part Number: D350636011

Job Number:



Seq. #:

Machine Or Operation:

Description :

47.0

D36721

Phenolic Washer



Comment: Qty.: 8.0000 Each(s)/Unit Total : 8.0000 Each(s)

Phenolic Washer

1339275

22

48.0

HAND FINISHING1

HAND FINISHING RESOURCE #1



Comment: HAND FINISHING RESOURCE #1

✓

1-Inspect for Foreign Objects

✓

2-Spray inside of tube with "LPS-3" batch: M107912

3-Install blade fitting D3488-041, wearshoes and ground handling hardware as per dwg D2750

SIKA FLEX 241

2 BATCH: M108801

EXP DATE: 08/10

4-Coat all exposed fasteners with "LPS Procyon"

batch:

M104251

22

08.08.06 x

49.0

QC5

INSPECT WORK TO CURRENT STEP



Comment: INSPECT WORK TO CURRENT STEP

See 08/06/06 x

50.0

PACKAGING 1

PACKAGING RESOURCE #1



CHG 004 M 06.07.22



Comment: PACKAGING RESOURCE #1

Pick Packing Kit

51.0

D2741

Blade, 350 Skidtube



Comment: Qty.: 1.0000 Each(s)/Unit Total : 1.0000 Each(s)

Blade

Batch: B38558

52.0

AN8C21A

BOLT



Comment: Qty.: 2.0000 Each(s)/Unit Total : 2.0000 Each(s)

Bolt

Batch: M107924

8/8/6

50

W/O:		WORK ORDER CHANGES						
DATE	STEP	PROCEDURE CHANGE	By	Date	Qty	Approval Chief Eng / Prod Mgr	Approval QC Inspector	

Part No: _____ PAR #: _____ Fault Category: _____ NCR: Yes No DQA: _____ Date: _____

QA: N/C Closed: _____ Date: _____

NCR:		WORK ORDER NON-CONFORMANCE (NCR)						
DATE	STEP	Description of NC Section A	Corrective Action Section B			Verification Section C	Approval Chief Eng	Approval QC Inspector
			Initial Chief Eng	Action Description Chief Eng	Sign & Date			

NOTE: Date & initial all entries

Date: Tuesday, 22/07/2008 11:22:06 AM
User: Julie Lecocq

Process Sheet

Customer: CU-DAR001 Dart Helicopters Services

Drawing Name: 350 SKIDTUBE ASSEMBLY LH

Job Number: 40696

Part Number: D350636011

Job Number:



Seq. #:	Machine Or Operation:	Description :
---------	-----------------------	---------------

53.0	AN960C816L	WASHER
------	------------	--------



Comment: Qty.: 2.0000 Each(s)/Unit Total : 2.0000 Each(s)

Washer

Batch: M107520

SP

54.0	NAS1515H8L	WASHER
------	------------	--------



Comment: Qty.: 2.0000 Each(s)/Unit Total : 2.0000 Each(s)

WASHER

Batch: M107581

SP

55.0	MS21083C8	NUT
------	-----------	-----



Comment: Qty.: 2.0000 Each(s)/Unit Total : 2.0000 Each(s)

Nut

Batch: M108744

SP

56.0	D34931	Washer
------	--------	--------



Comment: Qty.: 2.0000 Each(s)/Unit Total : 2.0000 Each(s)

WASHER

Batch: B39985

SP

57.0	D35321	Spacer
------	--------	--------



Comment: Qty.: 2.0000 (s)/Unit Total : 2.0000 (s)

batch:

B38594

8/8/6

(X)

58.0	QC4	INSPECT 100% KITS FOR COMPLETENESS
------	-----	------------------------------------



Comment: INSPECT 100% KITS FOR COMPLETENESS

8/8/7 (X)

59.0	PACKAGING 1	PACKAGING RESOURCE #1
------	-------------	-----------------------



Comment: PACKAGING RESOURCE #1

Package as per PPP D350-636-011

CHG 004

06.09.22

(X)
SO

W/O:		WORK ORDER CHANGES						
DATE	STEP	PROCEDURE CHANGE	By	Date	Qty	Approval Chief Eng / Prod Mgr	Approval QC Inspector	

Part No: _____ PAR #: _____ Fault Category: _____ NCR: Yes No DQA: _____ Date: _____

QA: N/C Closed: _____ Date: _____

NCR:		WORK ORDER NON-CONFORMANCE (NCR)						
DATE	STEP	Description of NC Section A	Corrective Action Section B			Verification Section C	Approval Chief Eng	Approval QC Inspector
			Initial Chief Eng	Action Description Chief Eng	Sign & Date			

NOTE: Date & initial all entries

Date: Tuesday, 22/07/2008 11:22:06 AM
User: Julie Lecocq

Process Sheet

Customer: CU-DAR001 Dart Helicopters Services

Drawing Name: 350 SKIDTUBE ASSEMBLY LH

Job Number: 40696

Part Number: D350636011

Job Number:



Seq. #:

Machine Or Operation:

Description :

60.0

QC21

FINAL INSPECTION/W/O RELEASE



①

Comment: FINAL INSPECTION/W/O RELEASE

2008/08/11

Job Completion



MF 08-08-08

B40696

W/O:		WORK ORDER CHANGES						
DATE	STEP	PROCEDURE CHANGE	By	Date	Qty	Approval Chief Eng / Prod Mgr	Approval QC Inspector	

Part No: _____ PAR #: _____ Fault Category: _____ NCR: Yes No DQA: _____ Date: _____

QA: N/C Closed: _____ Date: _____

NCR:		WORK ORDER NON-CONFORMANCE (NCR)						
DATE	STEP	Description of NC Section A	Corrective Action Section B			Verification Section C	Approval Chief Eng	Approval QC Inspector
			Initial Chief Eng	Action Description Chief Eng	Sign & Date			

NOTE: Date & initial all entries

DART**RELEASED**
07-08-02

DESIGN <i>PH</i>	DRAWN BY <i>CB</i>	DART AEROSPACE USA, INC. PORT HADLOCK, WA	
CHECKED <i>PH</i>	APPROVED <i>HA</i>	DRAWING NO. D2750	REV. E SHEET 1 OF 5
DATE 07.05.17		TITLE 350 SKIDTUBE ASSEMBLY SCALE NTS	
REV	DATE	DESCRIPTION	
A	98.04.16	NEW ISSUE	
B	98.09.01	CHANGE MS24694-S293 TO AN8-16A	
C	98.11.18	ADD D2750-3 / D2750-4; INCORPORATE D2738 AND D2740	
D	06.01.05	ADD HOLES AND SPACERS FOR APICAL FLOATS INCORPORATE DEO 9133 / 9157	
E	07.05.17	CHANGE TO STAINLESS STEEL WEARPLATES; ADD RUBBER GASKETS; CHANGE INSERTS; ADD D3631-1; REMOVE QTY(38) NAS1515H3L; REMOVE QTY(10) NAS1515H8L; REMOVE D2741, QTY(2) AN960C816; REMOVE QTY(2) MS21083C8	

Qty -041	Qty -042	Qty -043	Qty -044	Part Number	Description
X				D2750-041	SKIDTUBE ASSEMBLY, LH
	X			D2750-042	SKIDTUBE ASSEMBLY, RH
		X		D2750-043	SKIDTUBE ASSEMBLY, LH
			X	D2750-044	SKIDTUBE ASSEMBLY, RH
1	1	1	1	D2739	WEB
8	8	8	8	D2743	SPACER
1	1	1	1	D2744	CAP
8	8	8	8	D2745	BUSHING
1				D2750-1	SKIDTUBE WELDMENT, LH
	1			D2750-2	SKIDTUBE WELDMENT, RH
		1		D2750-3	SKIDTUBE WELDMENT, LH
			1	D2750-4	SKIDTUBE WELDMENT, RH
1		1		D3488-041	BLADE FITTING, LH
	1		1	D3488-042	BLADE FITTING, RH
4	4	4	4	D3490-1	SPACER
4	4			D3490-3	SPACER
		4	4	D3490-5	SPACER
8	8	8	8	D3492-041	PLUG ASSEMBLY
8	8			D3492-043	PLUG ASSEMBLY
		8	8	D3492-045	PLUG ASSEMBLY
1	1	1	1	D3535-13 <i>03291-1</i>	WEARSHOE
1	1	1	1	D3535-25	WEARSHOE
1	1	1	1	D3535-25 <i>03291-3</i>	WEARSHOE
1	1	1	1	D3535-25 <i>03293-1</i>	GASKET
1	1	1	1	D3536-25	GASKET
1	1	1	1	D3536-25 <i>03293-3</i>	GASKET
8 <i>2</i>	8 <i>2</i>	8 <i>2</i>	8 <i>2</i>	D3537-1	WEARPAD
8	8	8	8	D3631-1	WASHER
42	42	42	42	ALS4-1032-225	INSERT (OR ALS7-1032-225, AKS4-1032-225, AELS-1032-225)
38 <i>4</i>	38 <i>4</i>	38 <i>4</i>	38 <i>4</i>	AN3C5A	BOLT
4	4	4	4	AN3C6A	BOLT
4	4	4	4	AN3C7A	BOLT
4	4	4	4	AN6C44A	BOLT
1	1	1	1	AN8C35A	BOLT
46	46	46	46	AN960C10L	WASHER
21 <i>2</i>	21 <i>2</i>	21 <i>2</i>	21 <i>2</i>	AN960C816L	WASHER
4	4	4	4	MS21043-6	NUT
1	1	1	1	MS21083C8	NUT
4	4	4	4	NAS1515H3L	WASHER
2	2	2	2	NAS1515H8L	WASHER

PH 07.07.02
UNDER REVIEW
07.06.27
UPDATE
PER
NSI 9419

SHOP COPY
RETURN TO
ENGINEERING
UNCONTROLLED COPY
SUBJECT TO AMENDMENT
WITHOUT NOTICE
WORK ORDER
NO. *40096*

COPYRIGHT © 1998 BY DART AEROSPACE USA, INC.

THIS DOCUMENT IS PRIVATE AND CONFIDENTIAL AND IS SUPPLIED ON THE EXPRESS CONDITION THAT IT IS NOT TO BE USED FOR ANY PURPOSE OR COPIED OR COMMUNICATED TO ANY OTHER PERSON WITHOUT WRITTEN PERMISSION FROM DART AEROSPACE USA, INC.



DESIGN <i>PH</i>	DRAWN BY <i>CB</i>	DART AEROSPACE USA, INC. PORT HADLOCK, WA	
CHECKED <i>PH</i>	APPROVED <i>[Signature]</i>	DRAWING NO. D2750	REV. E SHEET 2 OF 5
DATE 07.05.17		TITLE 350 SKIDTUBE ASSEMBLY SCALE NTS	

GENERAL NOTES:

RELEASED
07-08-02 *[Signature]*

1. ALL DIMENSIONS ARE IN INCHES.
2. TOLERANCES ARE PER DART QSI 018 UNLESS OTHERWISE NOTED.
3. MAKE FROM D2600-3 EXTRUSION (INITIAL LENGTH = 120.0).
4. DAMAGE TOLERANCE ON BENDING:
THERE SHOULD BE NO VISIBLE WRINKLES IN THE BEND FROM THE GROUND TO A HEIGHT OF 12 INCHES ABOVE THE GROUND. NO GOUGING IS ACCEPTABLE IN THE FLAT PORTION OF THE TUBE. GOUGES UP TO 0.020 ARE ACCEPTABLE IN THE BENT PORTION OF THE TUBE. TUBE O.D. SHOULD BE 3.150 ± 0.010 IN THE FLAT PORTION OF THE TUBE. TUBE O.D. SHOULD BE 3.15 ± 0.030 IN THE BENT PORTION OF THE TUBE.
5. ALL HOLES DRILLED ON CENTERLINES EXCEPT THOSE NOTED BY SECTIONS C-C, D-D AND F-F.
6. WELDING TO BE DONE PER DART QSI 004.
7. FINAL CONFIGURATION SHOULD HAVE THE FOLLOWING MINIMUM MECHANICAL PROPERTIES:
MINIMUM YIELD TENSILE STRENGTH = 35 ksi
MINIMUM ULTIMATE TENSILE STRENGTH = 38 ksi
8. FINISH:
ACID ETCH, ALODINE ASSEMBLY PER DART QSI 005 4.1 PRIOR TO INSTALLING D2739 WEB.
POWDER COAT WHITE (REF. 4.3.5.1) PER DART QSI 005 4.3
BLACK ANTI-SKID PAINT AS INDICATED TO 1.0 ABOVE SKIDTUBE CENTER-LINE PER DART 005 4.4 (OPTIONAL).
9. INSTALL ALS4-1032-225 INSERTS AFTER FINISH AS INDICATED IN D2750-1/-2/-3/-4 UNCONTROLLED COPY WELDING DETAIL ON PAGE 4 AND 5. DRILL 'F' SIZE HOLES ($\emptyset 0.297$) FOR WEARSHOE INSERTS.
10. D3488-041 (OR D3488-042) BLADE FITTING AND AN3C5A/AN3C7A WEARSHOE BOLTS NO. *40096* TO BE INSTALLED USING SIKAFLEX-241 (OR EQUIVALENT) SEALANT.
11. SPRAY INSIDE OF TUBE WITH A COAT OF LPS LABORATORIES "LPS-3" AFTER FINISH AND AFTER INSTALLATION OF INSERTS. COAT ALL EXPOSED FASTENERS WITH LPS LABORATORIES "LPS PROCYON" AFTER FINAL ASSEMBLY, CLEAN EXCESS OFF POWDER COATING WITH MEK DEGREASER.


SHOP COPY
RETURN TO
ENGINEERING

WITHOUT NOTICE
WORK ORDER


UNDER REVIEW
07.06.2017
UPDATE
PER
NSI 9418

COPYRIGHT © 1998 BY DART AEROSPACE USA, INC.





THIS DOCUMENT IS PRIVATE AND CONFIDENTIAL AND IS SUPPLIED ON THE EXPRESS CONDITION THAT IT IS NOT TO BE USED FOR ANY PURPOSE OR COPIED OR COMMUNICATED TO ANY OTHER PERSON WITHOUT WRITTEN PERMISSION FROM DART AEROSPACE USA, INC.

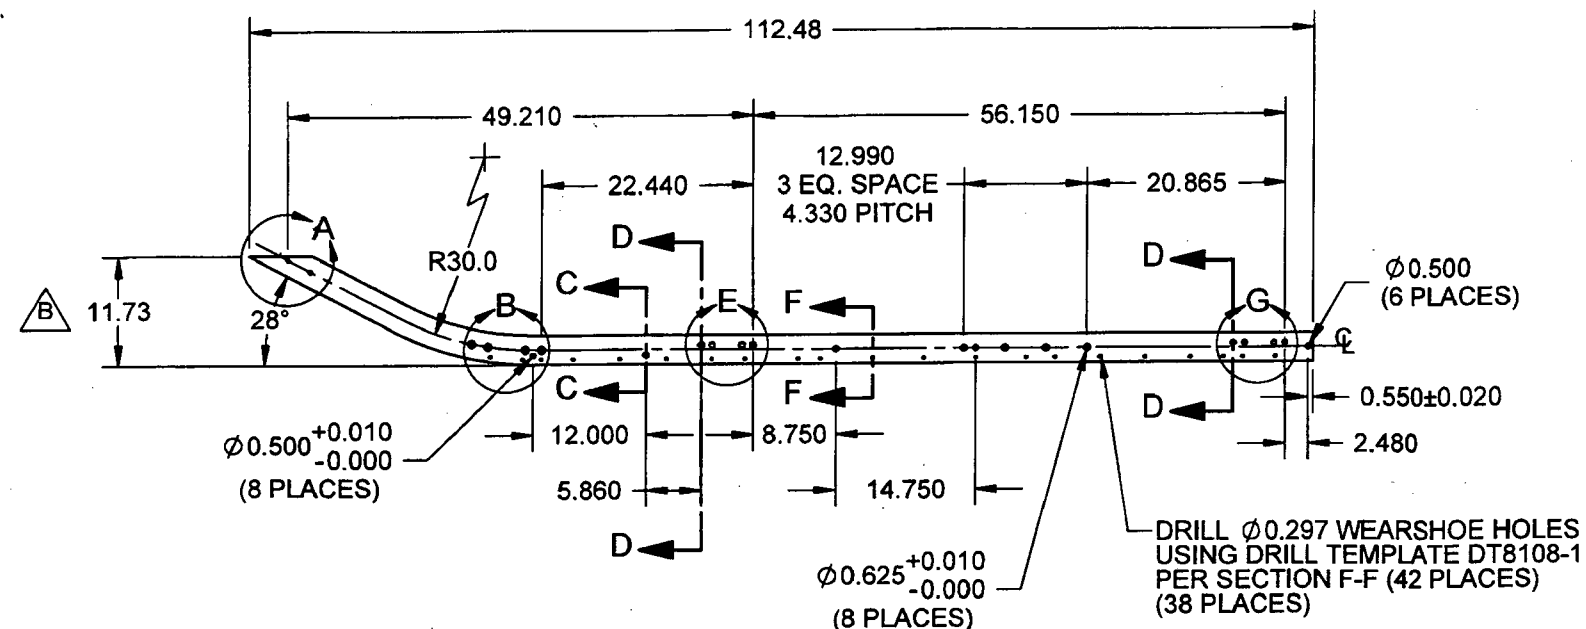


**D2750-1 LH SKIDTUBE (SHOWN)
D2750-2 RH SKIDTUBE (OPPOSITE)**

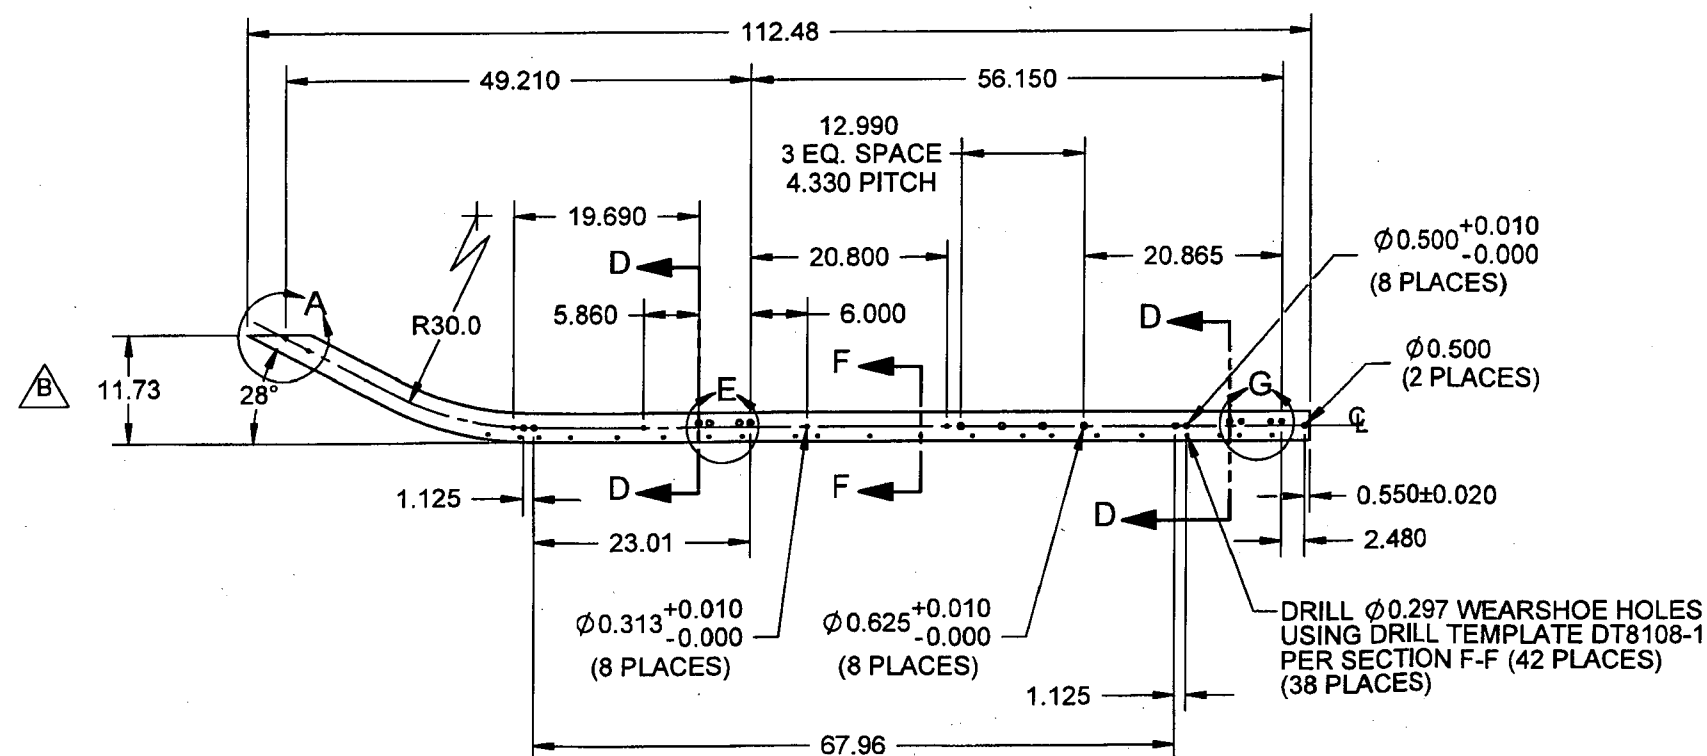


**D2750-3 LH SKIDTUBE (SHOWN)
D2750-4 RH SKIDTUBE (OPPOSITE)**

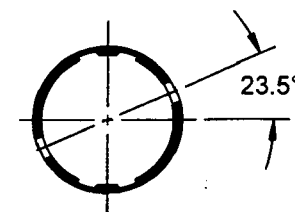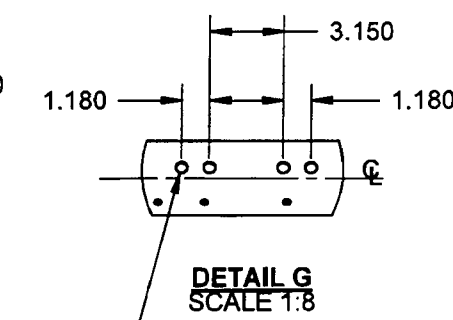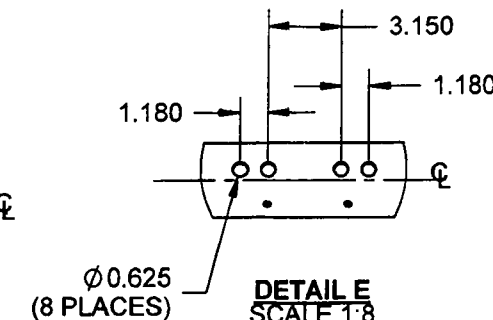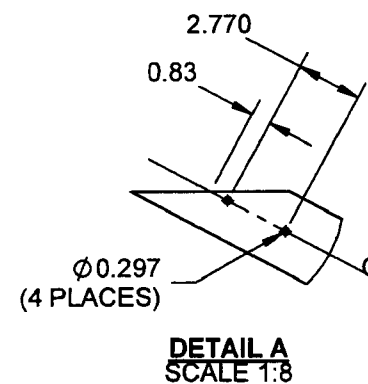

**SECTION C-C
SCALE 1:4**

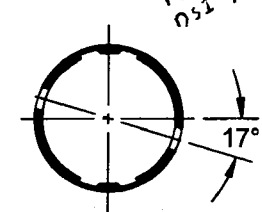


**SECTION D-D
SCALE 1:4**

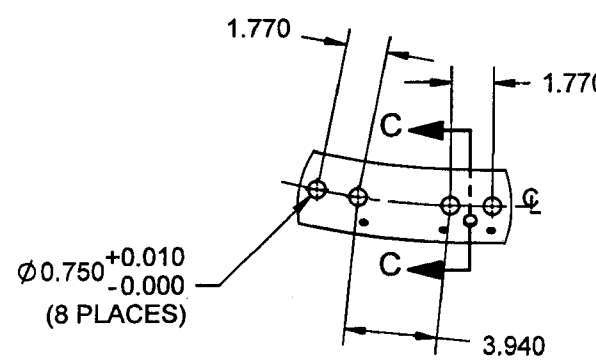

**DETAIL B
SCALE 1:8
(ALL DIMENSIONS ARE
STRAIGHT LINE DIMENSIONS)**


RELEASED
07-08-02

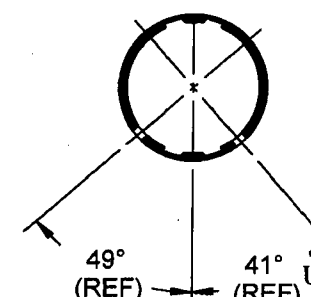


**SECTION F-F
SCALE 1:4**

SHOP COPY
RETURN TO
ENGINEERING
UNCONTROLLED COPY
SUBJECT TO AMENDMENT
WITHOUT NOTICE
WORK ORDER
NO. 40696

DESIGN <i>PH</i>	DRAWN BY <i>CB</i>	DART AEROSPACE USA, INC. PORT HADLOCK, WA	
CHECKED <i>PH</i>	APPROVED <i>[Signature]</i>	DRAWING NO. D2750	REV. E SHEET 3 OF 5
DATE 07.05.17		TITLE 350 SKIDTUBE ASSEMBLY	SCALE 1:20
COPYRIGHT © 1998 BY DART AEROSPACE USA, INC. THIS DOCUMENT IS PRIVATE AND CONFIDENTIAL AND IS SUPPLIED ON THE EXPRESS CONDITION THAT IT IS NOT TO BE USED FOR ANY PURPOSE OR COPIED OR COMMUNICATED TO ANY OTHER PERSON WITHOUT WRITTEN PERMISSION FROM DART AEROSPACE USA, INC.			

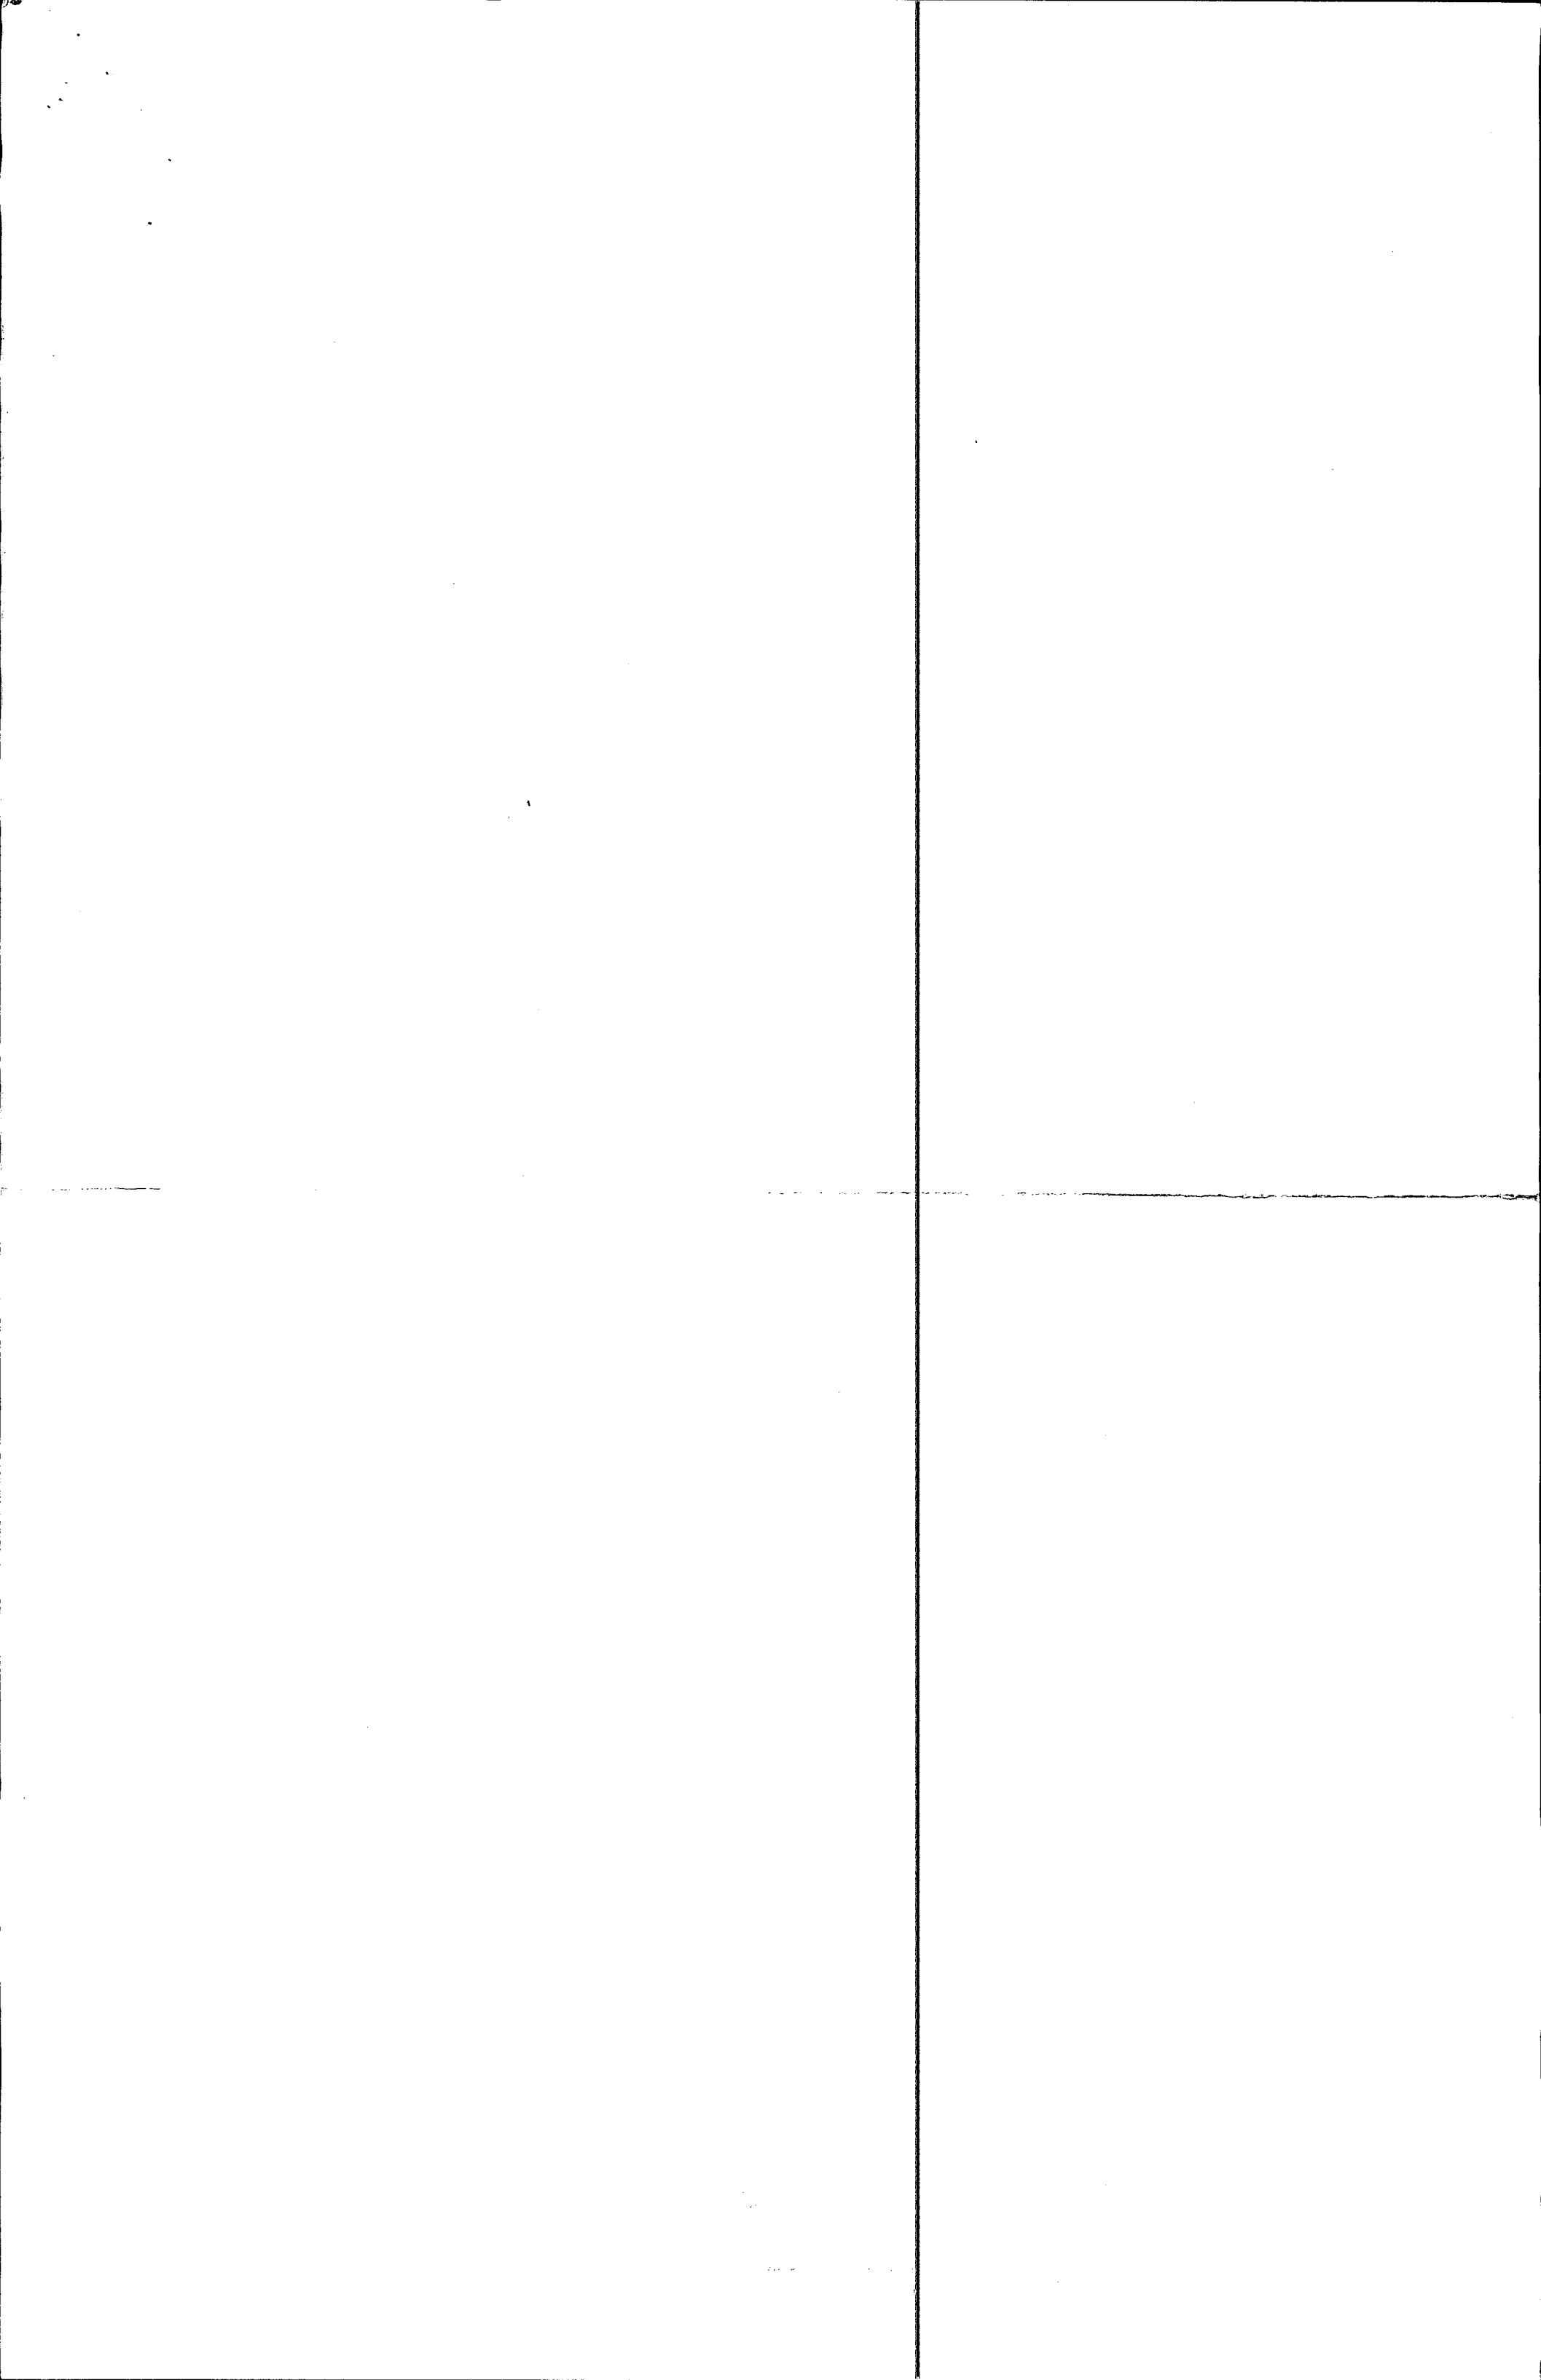

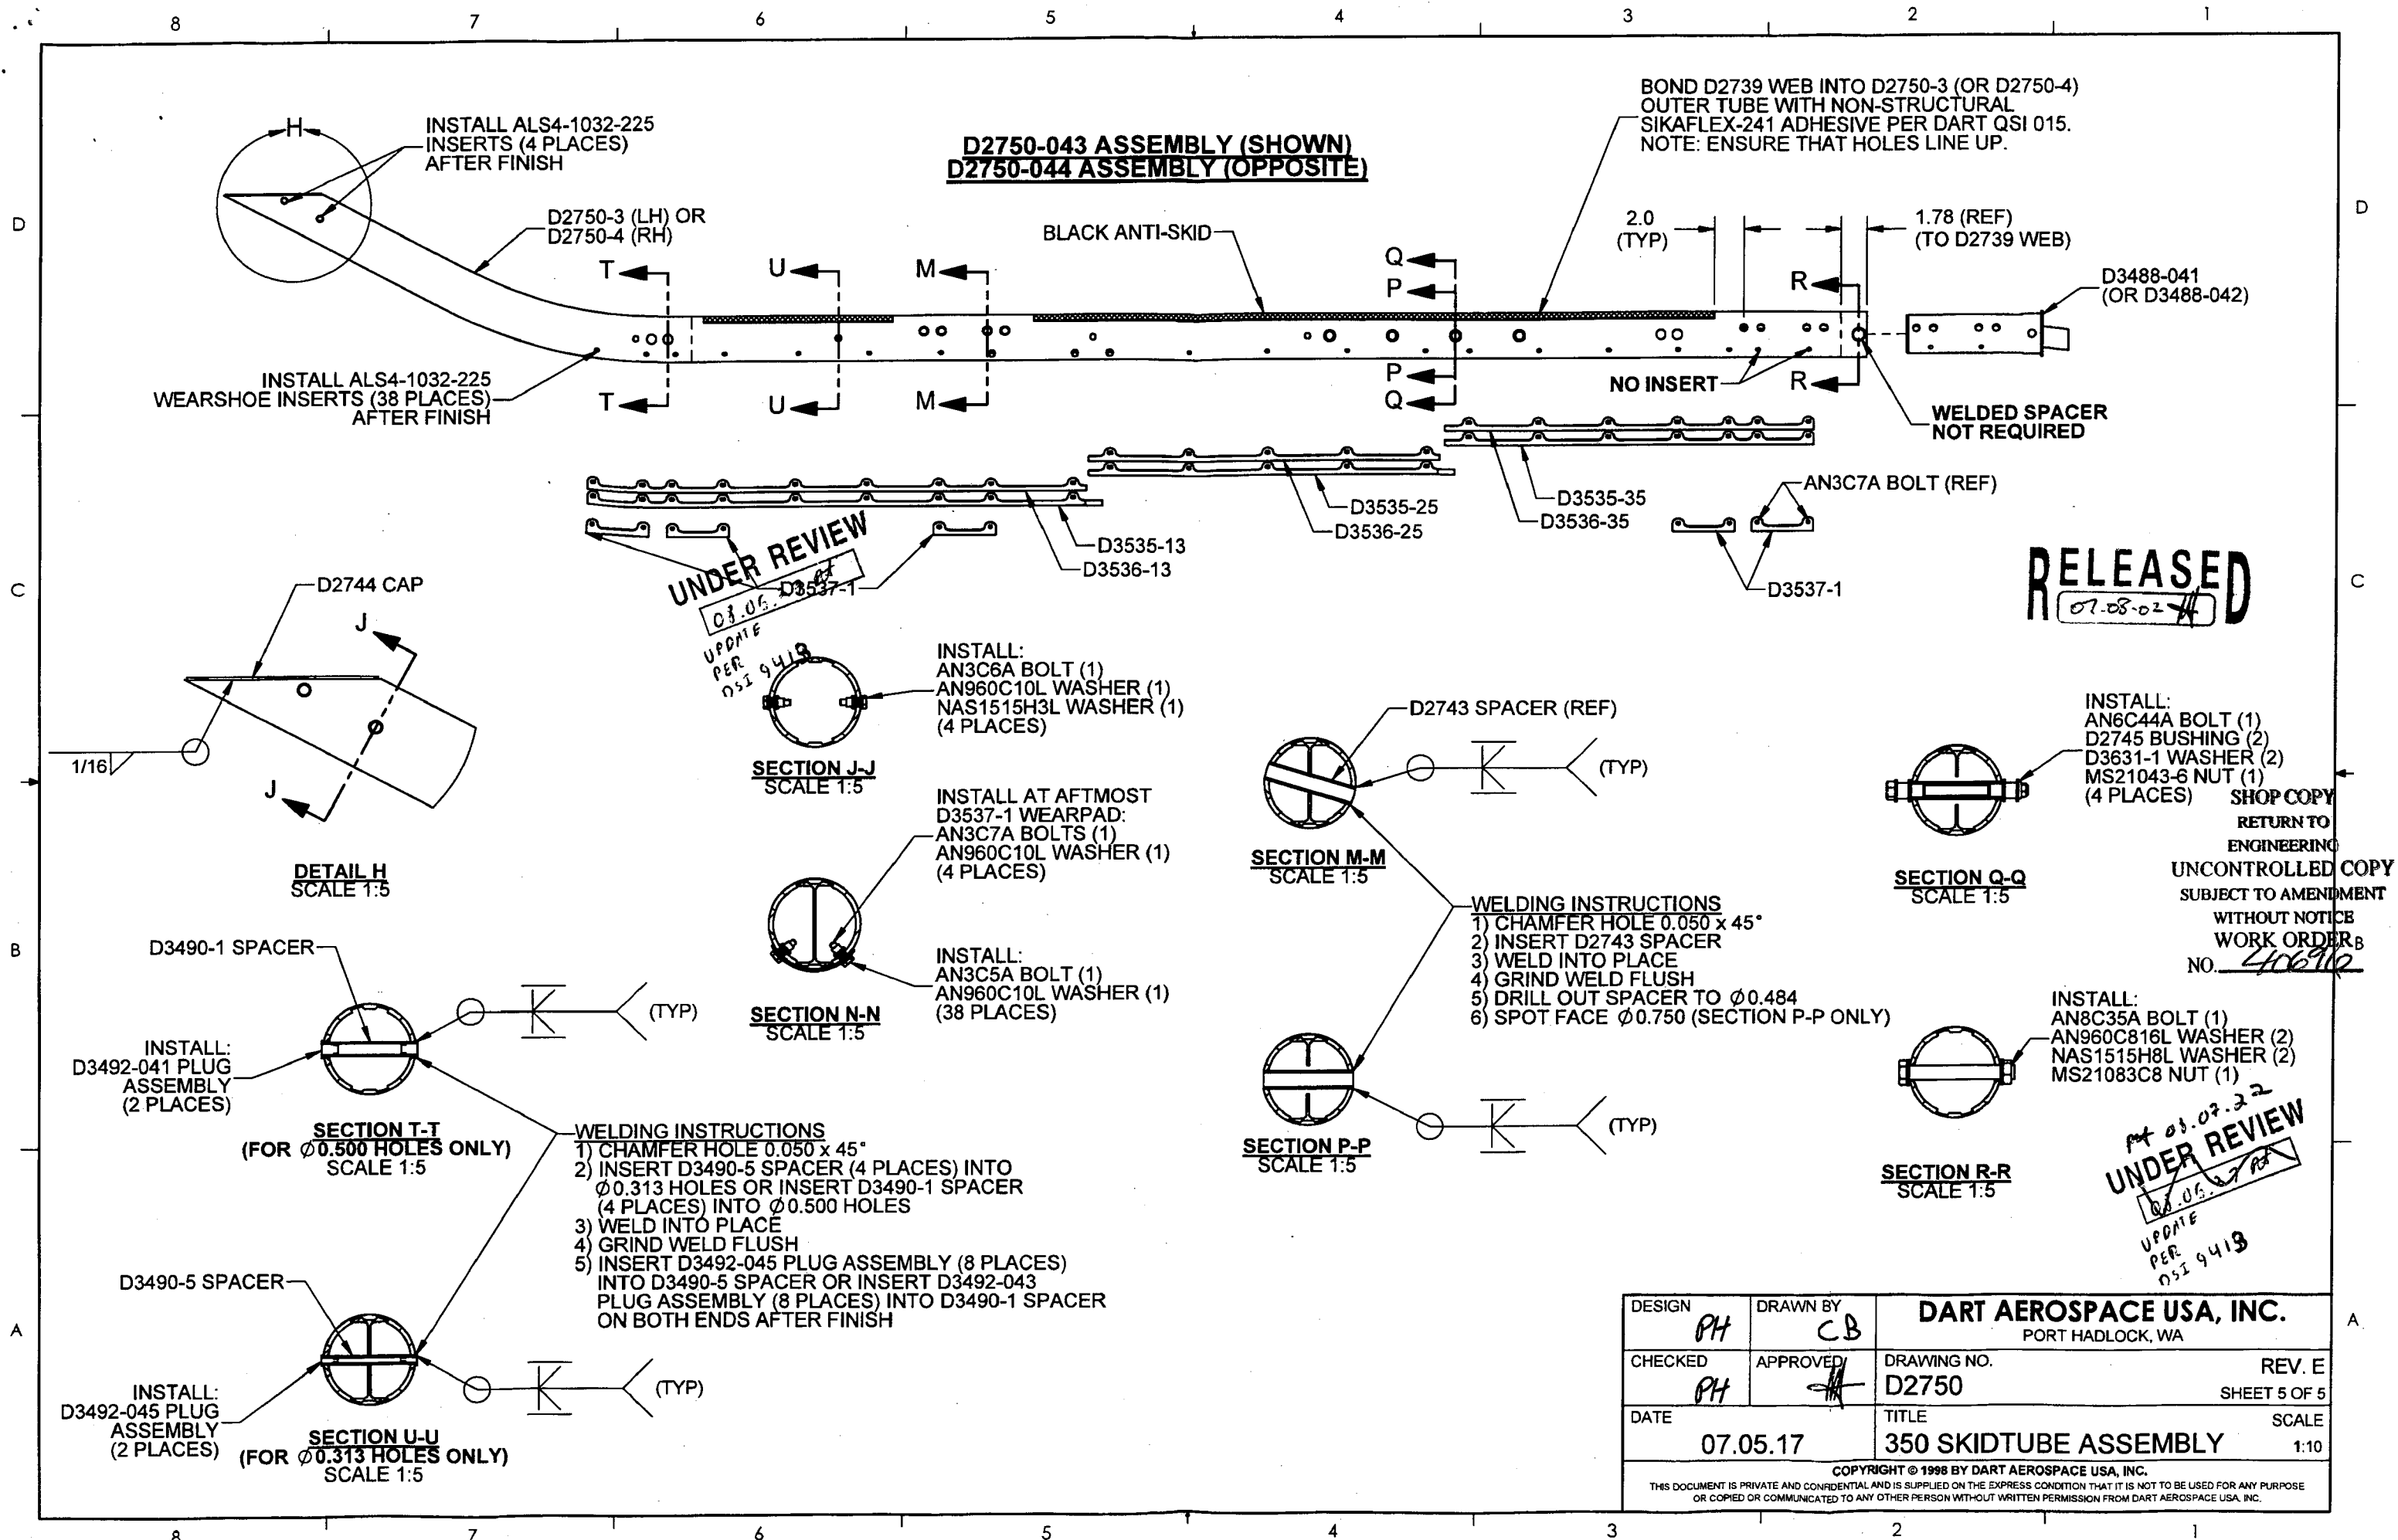

DART SERVICE INSTRUCTION


TO AMEND INSTALLATION INSTRUCTIONS IIN-D350-636 REV E

REF FAA STC: SR00646SE

REF CANADIAN STC: SH99-7

THE WEARPLATES ON D350-636-011/-012/-013/-014 SKIDTUBES AT CHG 004 (AND LATER) HAVE BEEN MODIFIED AS SHOWN IN FIGURE 1 BELOW TO ELIMINATE THE POSSIBILITY OF INTERFERENCE BETWEEN THE WEARPLATES AND CROSSTUBE SADDLES AT INSTALLATION. THERE IS NEGLIGIBLE WEIGHT CHANGE ASSOCIATED WITH THIS MODIFICATION.

WAS

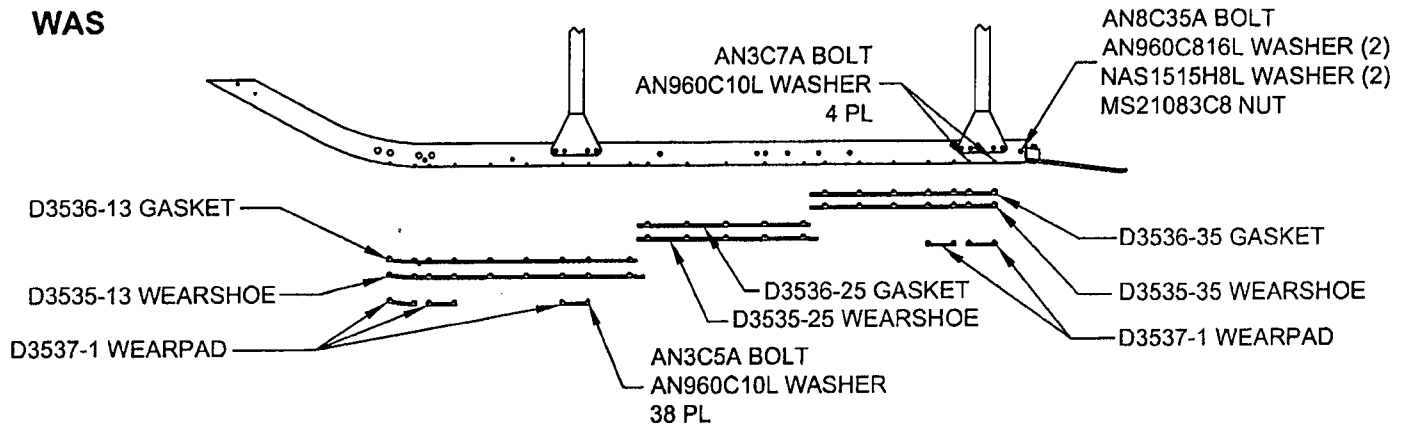

NOW

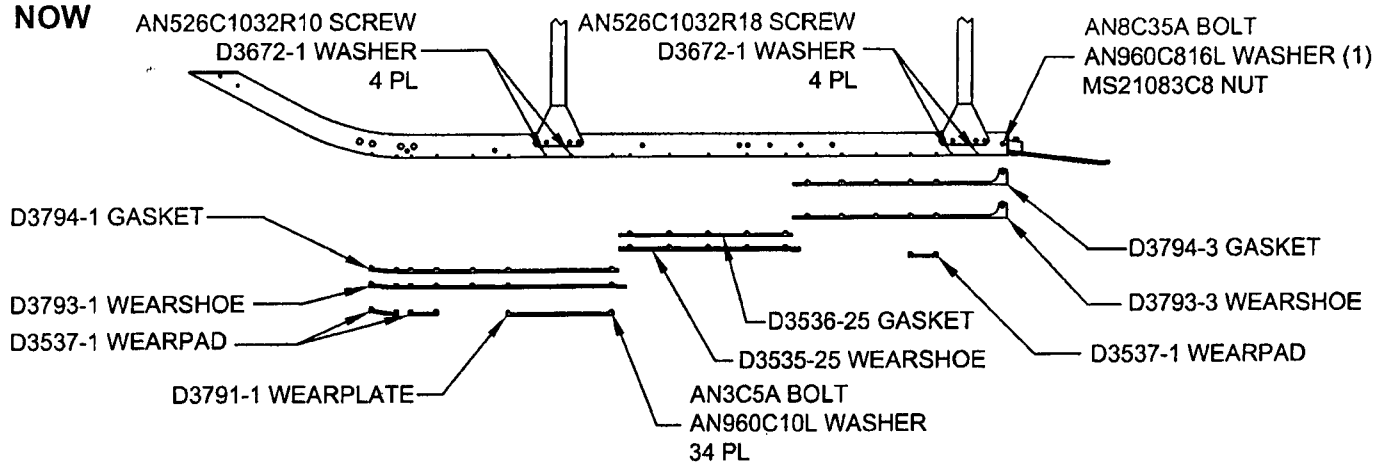


FIGURE 1 - WEARPLATE MODIFICATION

(AN526C1032RXX SCREW LOCATIONS NO LONGER USED TO MOUNT WEARSHOES)

SHOP COPY
RETURN TO
ENGINEERING
UNCONTROLLED COPY
SUBJECT TO AMENDMENT
WITHOUT NOTICE
WORK ORDER
NO. 40696

A	NEW ISSUE	PH	08.05.14
REV.	DESCRIPTION	BY	DATE
DESIGN	PH	DART AEROSPACE USA, INC PORT HADLOCK, WA	
DRAWN	PH		
CHECKED		DRAWING NO.	REV. A
MFG. APPR.	N/A	DSI 9413	SHEET 1 OF 3
APPROVED		TITLE	SCALE
DE APPR.		WEARSHOE MODIFICATION	NTS
DATE	08.05.14	COPYRIGHT © 2008 BY DART AEROSPACE USA, INC THIS DOCUMENT IS PRIVATE AND CONFIDENTIAL AND IS SUPPLIED ON THE EXPRESS CONDITION THAT IT IS NOT TO BE USED FOR ANY PURPOSE OR COPIED OR COMMUNICATED TO ANY OTHER PERSON WITHOUT WRITTEN PERMISSION FROM DART AEROSPACE USA, INC.	

FOR D350-636-011/-012/-013/-014 SKIDTUBES AT CHG 004, AMEND PARTS LIST OF IIN-D350-636 SECTION 5 AS FOLLOWS:

REMOVE:

Item	Qty -011	Qty -012	Qty -013	Qty -014	Part Number	Description
	X				D350-636-011	SKIDTUBE INSTALLATION, LH, STD AERAZUR/APICAL CYLINDRICAL FLOAT COMPATIBLE
		X			D350-636-012	SKIDTUBE INSTALLATION, RH, STD AERAZUR/APICAL CYLINDRICAL FLOAT COMPATIBLE
			X		D350-636-013	SKIDTUBE INSTALLATION, LH AIRCRUISER/ APICAL TRI-BAG FLOAT COMPATIBLE
				X	D350-636-014	SKIDTUBE INSTALLATION, RH AIRCRUISER/ APICAL TRI-BAG FLOAT COMPATIBLE
*6A	1	1	1	1	AN960C816L	WASHER
6B	2	2	2	2	NAS1515H8L	WASHER
*22	2	2	2	2	D3537-1	WEARPAD
23A	1	1	1	1	D3535-13	WEARSHOE
23B	1	1	1	1	D3536-13	GASKET
25A	1	1	1	1	D3535-35	WEARSHOE
25B	1	1	1	1	D3536-35	GASKET
*26A	4	4	4	4	AN3C5A	BOLT
*26B	4	4	4	4	AN3C7A	BOLT
*27	8	8	8	8	AN960C10L	WASHER

*SUBTRACT FROM TOTAL QUANTITY OF PARTS INDICATED IN INSTALLATION INSTRUCTIONS IIN-D350-636

ADD:

Qty -011	Qty -012	Qty -013	Qty -014	Part Number	Description
X				D350-636-011	SKIDTUBE INSTALLATION, LH, STD AERAZUR/APICAL CYLINDRICAL FLOAT COMPATIBLE
	X			D350-636-012	SKIDTUBE INSTALLATION, RH, STD AERAZUR/APICAL CYLINDRICAL FLOAT COMPATIBLE
		X		D350-636-013	SKIDTUBE INSTALLATION, LH AIRCRUISER/ APICAL TRI-BAG FLOAT COMPATIBLE
			X	D350-636-014	SKIDTUBE INSTALLATION, RH AIRCRUISER/ APICAL TRI-BAG FLOAT COMPATIBLE
1	1	1	1	D3791-1	WEARPLATE
1	1	1	1	D3793-1	WEARSHOE
1	1	1	1	D3793-3	WEARSHOE
1	1	1	1	D3794-1	GASKET
1	1	1	1	D3794-3	GASKET
8	8	8	8	D3672-1	WASHER
4	4	4	4	AN526C1032R10	SCREW
4	4	4	4	AN526C1032R18	SCREW

SHOP COPY
RETURN TO
ENGINEERING
UNCONTROLLED COPY
SUBJECT TO AMENDMENT
WITHOUT NOTICE
WORK ORDER
NO. 40596

DESIGN	<i>PH</i>	DART AEROSPACE USA, INC	
DRAWN	<i>PH</i>	PORT HADLOCK, WA	
CHECKED	<i>B</i>	DRAWING NO.	REV. A
MFG. APPR.	N/A	DSI 9413	SHEET 2 OF 3
APPROVED	<i>[Signature]</i>	TITLE	SCALE
DE APPR.	<i>[Signature]</i>	WEARSHOE MODIFICATION	NTS
DATE	08.05.14	COPYRIGHT © 2008 BY DART AEROSPACE USA, INC THIS DOCUMENT IS PRIVATE AND CONFIDENTIAL AND IS SUPPLIED ON THE EXPRESS CONDITION THAT IT IS NOT TO BE USED FOR ANY PURPOSE OR COPIED OR COMMUNICATED TO ANY OTHER PERSON WITHOUT WRITTEN PERMISSION FROM DART AEROSPACE USA, INC.	

TO IMPROVE THE INSTALLATION OF D350-636-011/-012/-013/-014 SKIDTUBES EQUIPPED WITH STAINLESS WEARPLATES/WEARPADS AND GASKETS (CHG 003) ONTO THE CROSSTUBES, THE FOLLOWING DSI 9413-011 WEARSHOE KIT CAN BE PROCURED FROM DART:

Qty -011	Part Number	Description
X	DSI 9413-011	WEARSHOE MODIFICATION KIT
1	D3791-1	WEARPLATE
1	D3793-1	WEARSHOE
1	D3793-3	WEARSHOE
1	D3794-1	GASKET
1	D3794-3	GASKET
8	D3672-1	WASHER
4	AN526C1032R10	SCREW
4	AN526C1032R18	SCREW

TO INSTALL THE DSI 9413-011 KIT, REMOVE THE EXISTING WEARSHOES/GASKETS UNDER THE FWD/AFT SADDLES AND INSTALL NEW WEARSHOES/GASKETS AS SHOWN IN FIGURE 1. PLUG UNUSED HOLES WITH AN526C1032RXX SCREWS AND D3672-1 WASHERS. INSTALL SCREWS WITH SIKAFLEX -241/-291 OR PROSEAL 890 OR MIL-S-8802 CLASS 'B2' SEALANT AS SHOWN IN FIGURE 1. NOTE: SOME OF THE PREVIOUSLY INSTALLED HARDWARE IS NO LONGER REQUIRED.

THE FOLLOWING D350-636-045 REPLACEMENT WEARPLATE KIT WILL BE AVAILABLE FOR D350-636-011/-012/-013/-014 SKIDTUBES AT CHG 004 OR LATER:

Qty -011	Part Number	Description
X	D350-636-045	WEARSHOE KIT
3	D3537-1	WEARPAD
1	D3535-25	WEARSHOE
1	D3536-25	GASKET
1	D3791-1	WEARPLATE
1	D3793-1	WEARSHOE
1	D3793-3	WEARSHOE
1	D3794-1	GASKET
1	D3794-3	GASKET
34	AN3C5A	BOLT
34	AN960C10L	WASHER

SHOP COPY
RETURN TO
ENGINEERING
UNCONTROLLED COPY
SUBJECT TO AMENDMENT
WITHOUT NOTICE
WORK ORDER
NO. 40596

DESIGN	PH	DART AEROSPACE USA, INC	
DRAWN	PH	PORT HADLOCK, WA	
CHECKED	PH	DRAWING NO.	REV. A
MFG. APPR.	N/A	DSI 9413	SHEET 3 OF 3
APPROVED	PH	TITLE	SCALE
DE APPR.	PH	WEARSHOE MODIFICATION	NTS
DATE	08.05.14	<small>COPYRIGHT © 2008 BY DART AEROSPACE USA, INC THIS DOCUMENT IS PRIVATE AND CONFIDENTIAL AND IS SUPPLIED ON THE EXPRESS CONDITION THAT IT IS NOT TO BE USED FOR ANY PURPOSE OR COPIED OR COMMUNICATED TO ANY OTHER PERSON WITHOUT WRITTEN PERMISSION FROM DART AEROSPACE USA, INC.</small>	

NO. 165

AWS D17.1.2001
QUALIFICATION TEST RECORD

Name: Berclay Elliot
Job number: 40696
Part number: D350 B&A
Description: 350 SKID
Welding Process: Tig[☒] Mig[]
Base material: Aluminium
Current: AC[☒] DC[]

TEST REQUIREMENTS AND RESULTS

Visual: pass[☒] fail[]
Penetration: pass[☒] fail[]

UNACCEPTABLE

Cracks: pass[☒] fail[]
Undercut: pass[☒] fail[]
Pin holes: pass[☒] fail[]
Overlap (cold lap): pass[☒] fail[]
Porosity (surface): pass[☒] fail[]
Coloration: pass[☒] fail[]

Qualifier Del Duval Date of Test Coupon 08-08-01
Welder Berclay Elliot Date of Test Coupon 08-08-01

The above named individual is qualified in accordance with AWS D17.1.2001 to weld